© Copyright 2009 by Croft & Associates, P.C. All rights reserved. This document is property of Croft & Associates, P.C. It is to be used only for the specific project referred to or identified herein and is not to be used on other projects. In whole or in part, except by the express written agreement of Croft & Associates, P.C.

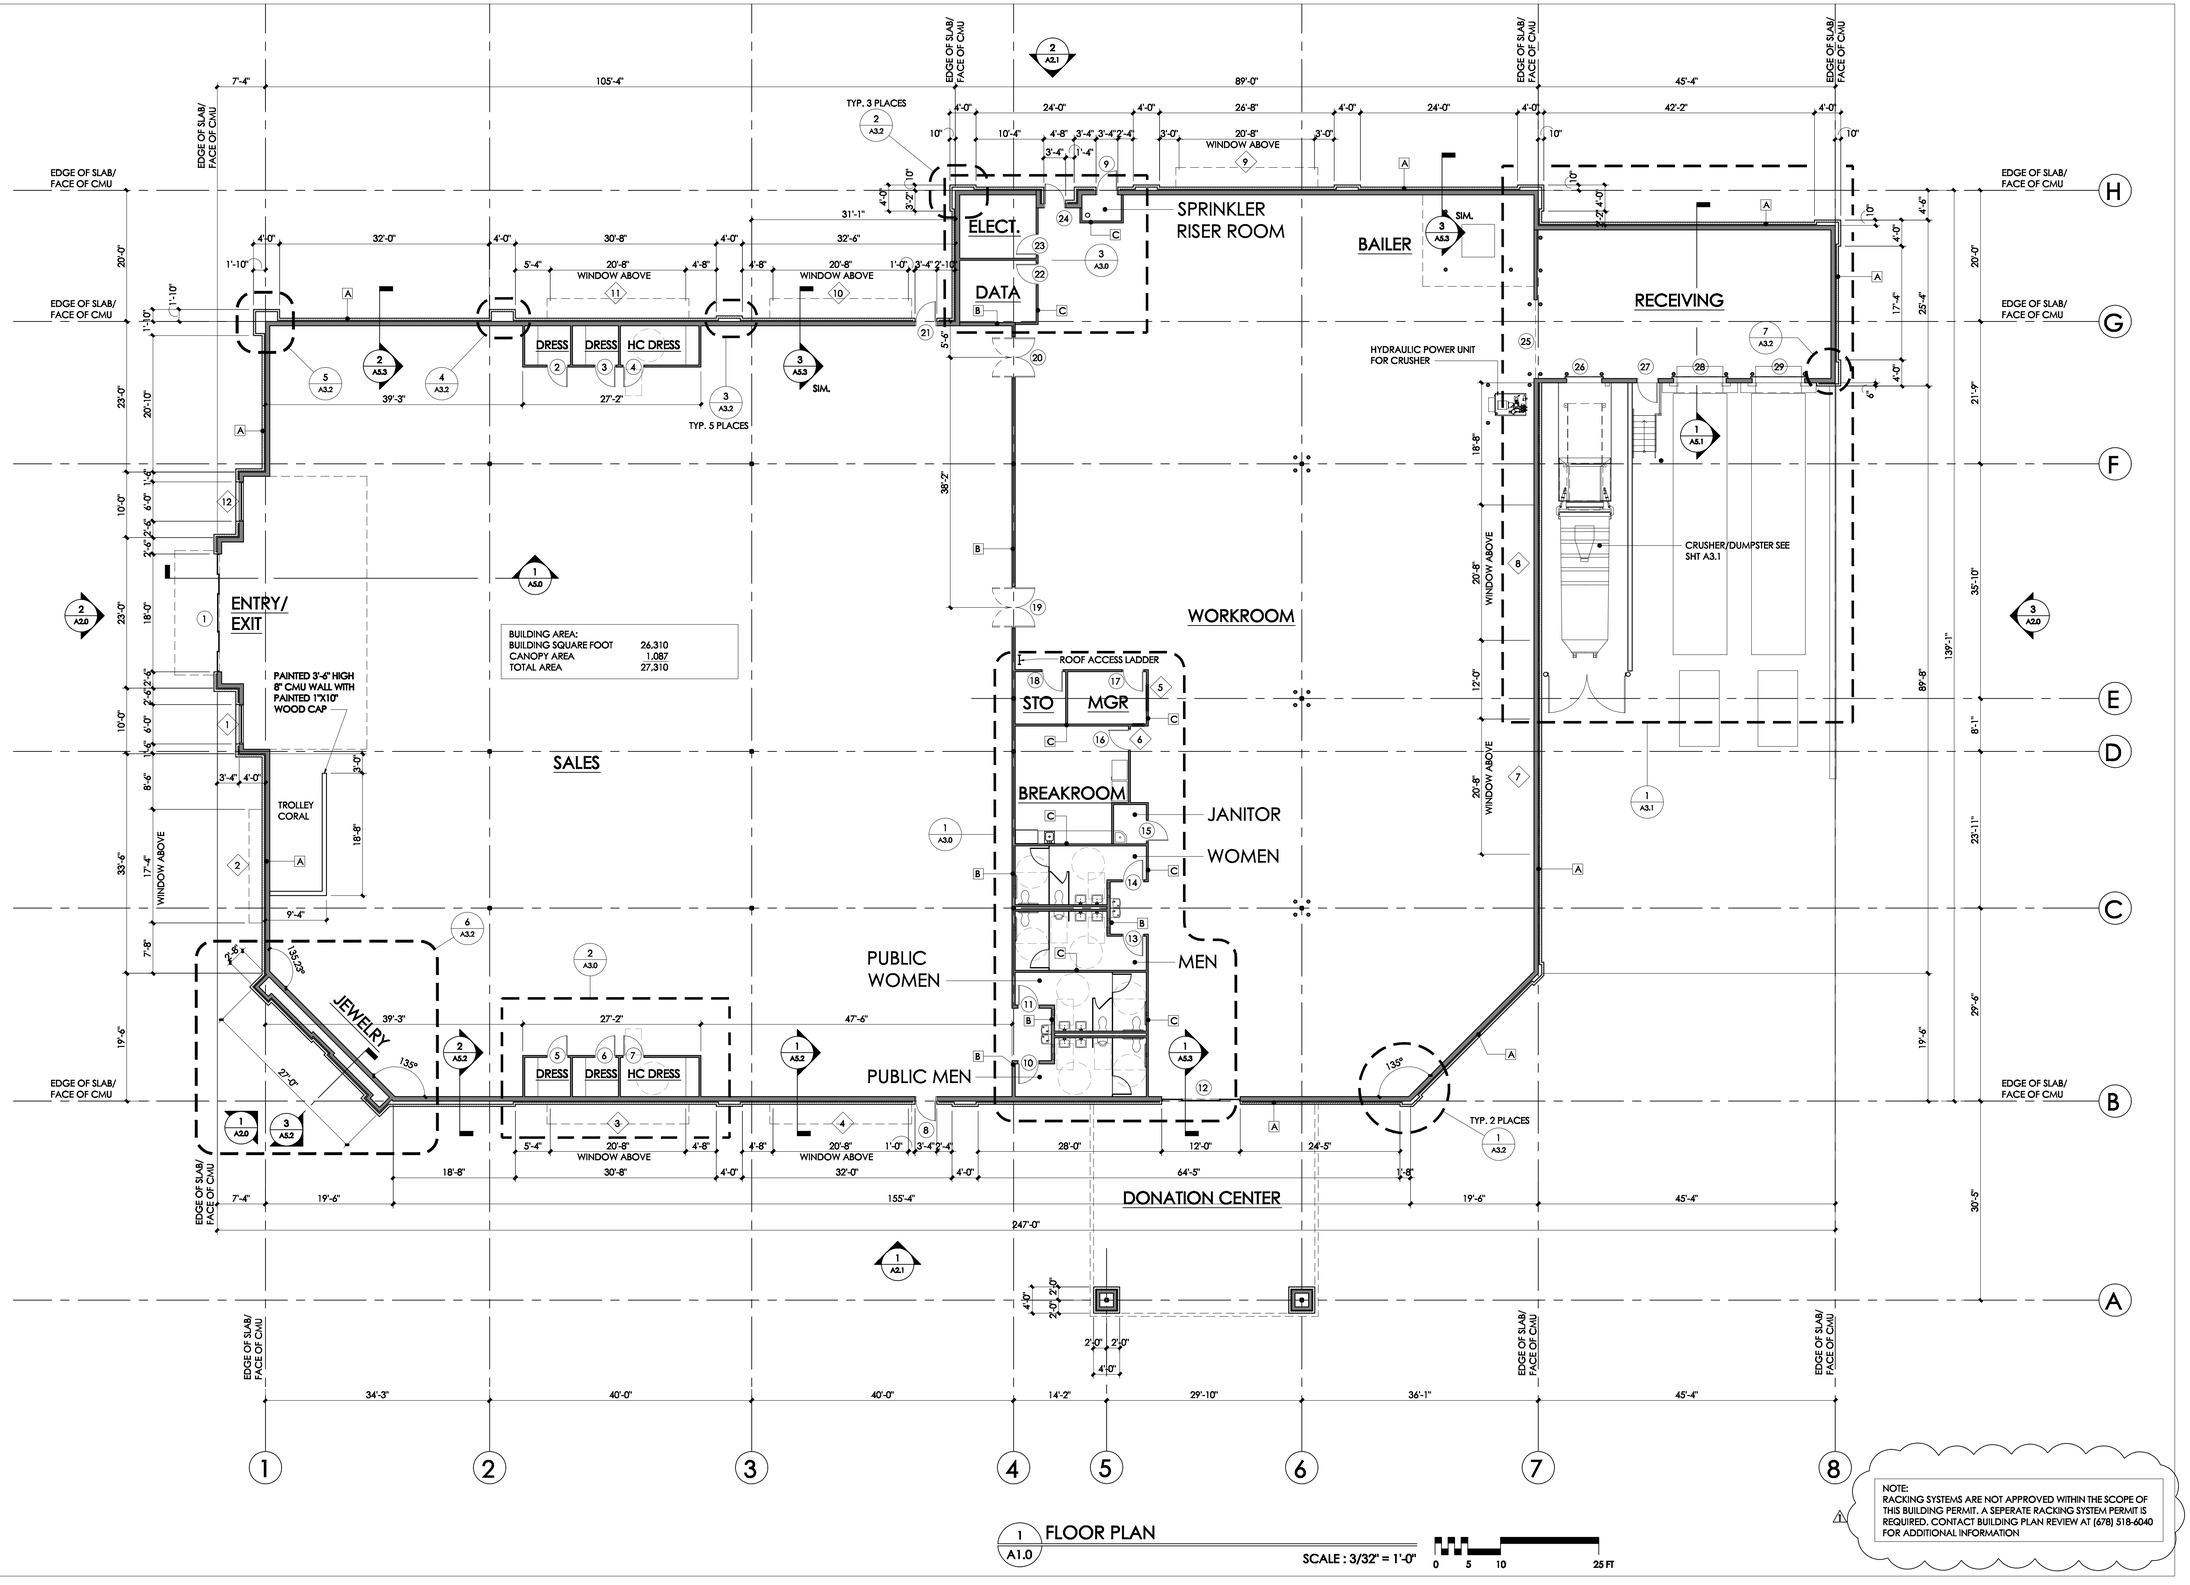


1 FLOOR PLAN A1.0

SCALE : 3/32" = 1'-0"

0 5 10 25 FT

NOTE:
RACKING SYSTEMS ARE NOT APPROVED WITHIN THE SCOPE OF THIS BUILDING PERMIT. A SEPERATE RACKING SYSTEM PERMIT IS REQUIRED. CONTACT BUILDING PLAN REVIEW AT (678) 518-6040 FOR ADDITIONAL INFORMATION

CROFT & Associates PC
3400 Blue Springs Road, Suite 200
Kennesaw, Georgia 30144
770.529.7714 (p) 770.529.7716 (f)
www.croftandassociates.com

STATE OF GEORGIA ★ ARCHITECT ★ REGISTERED ARCHITECT
JAMES H. CROFT, JR.
CERTIFICATE NO. 12589

Date: 04.17.2009 Drawn: SA Checked: BB

| # | Date | Description |
|---|---|---|
| 1 | 05.20.09 | REVISE PER COUNTY REVIEW |

GOODWILL @ HAMILTON MILL
3295 Sardis Church Road

29100
Project Number

Floor Plan
printed for construction

A1.0